



F.H.W.A. REGION NO.	STATE	FED. MD PROJ. NO.	SHEET NO.	TOTAL SHEETS
3	MD			





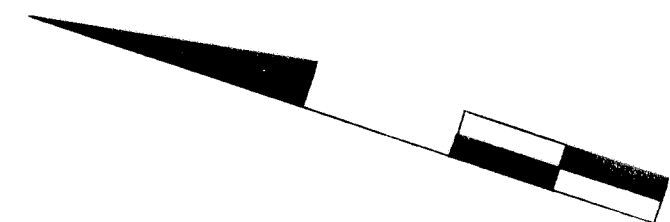


MD 322 IS ASSUMED TO RUN IN  
A NORTH-SOUTH DIRECTION.


#### SIGNALS

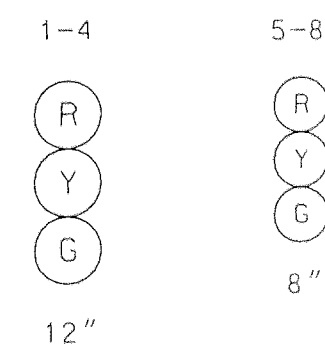


#### SIGNS

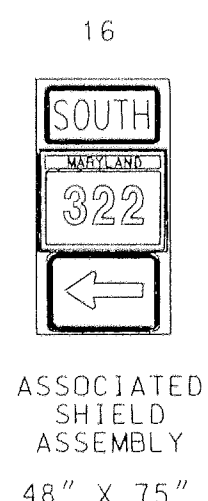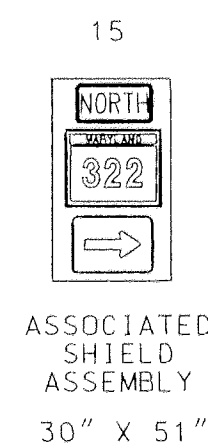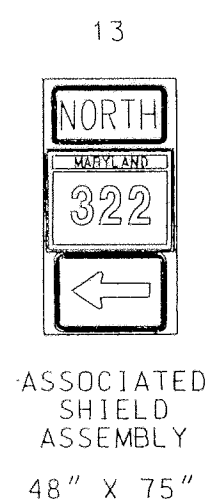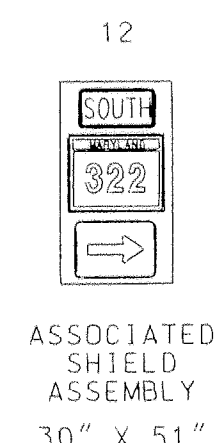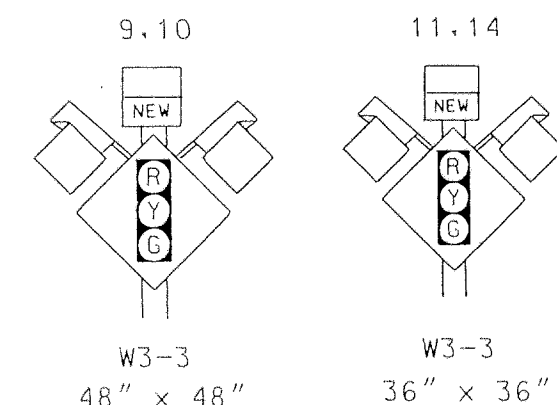

#### NEMA PHASING

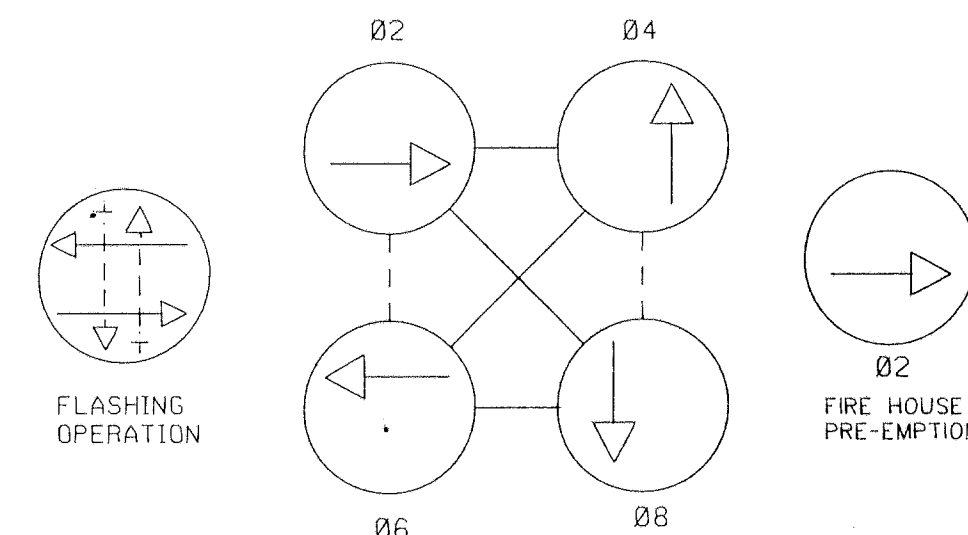

PHASES ASSOCIATED BY A DASHED LINE WILL OPERATE CONCURRENTLY  
PHASES ASSOCIATED BY A SOLID LINE WILL NOT OPERATE CONCURRENTLY

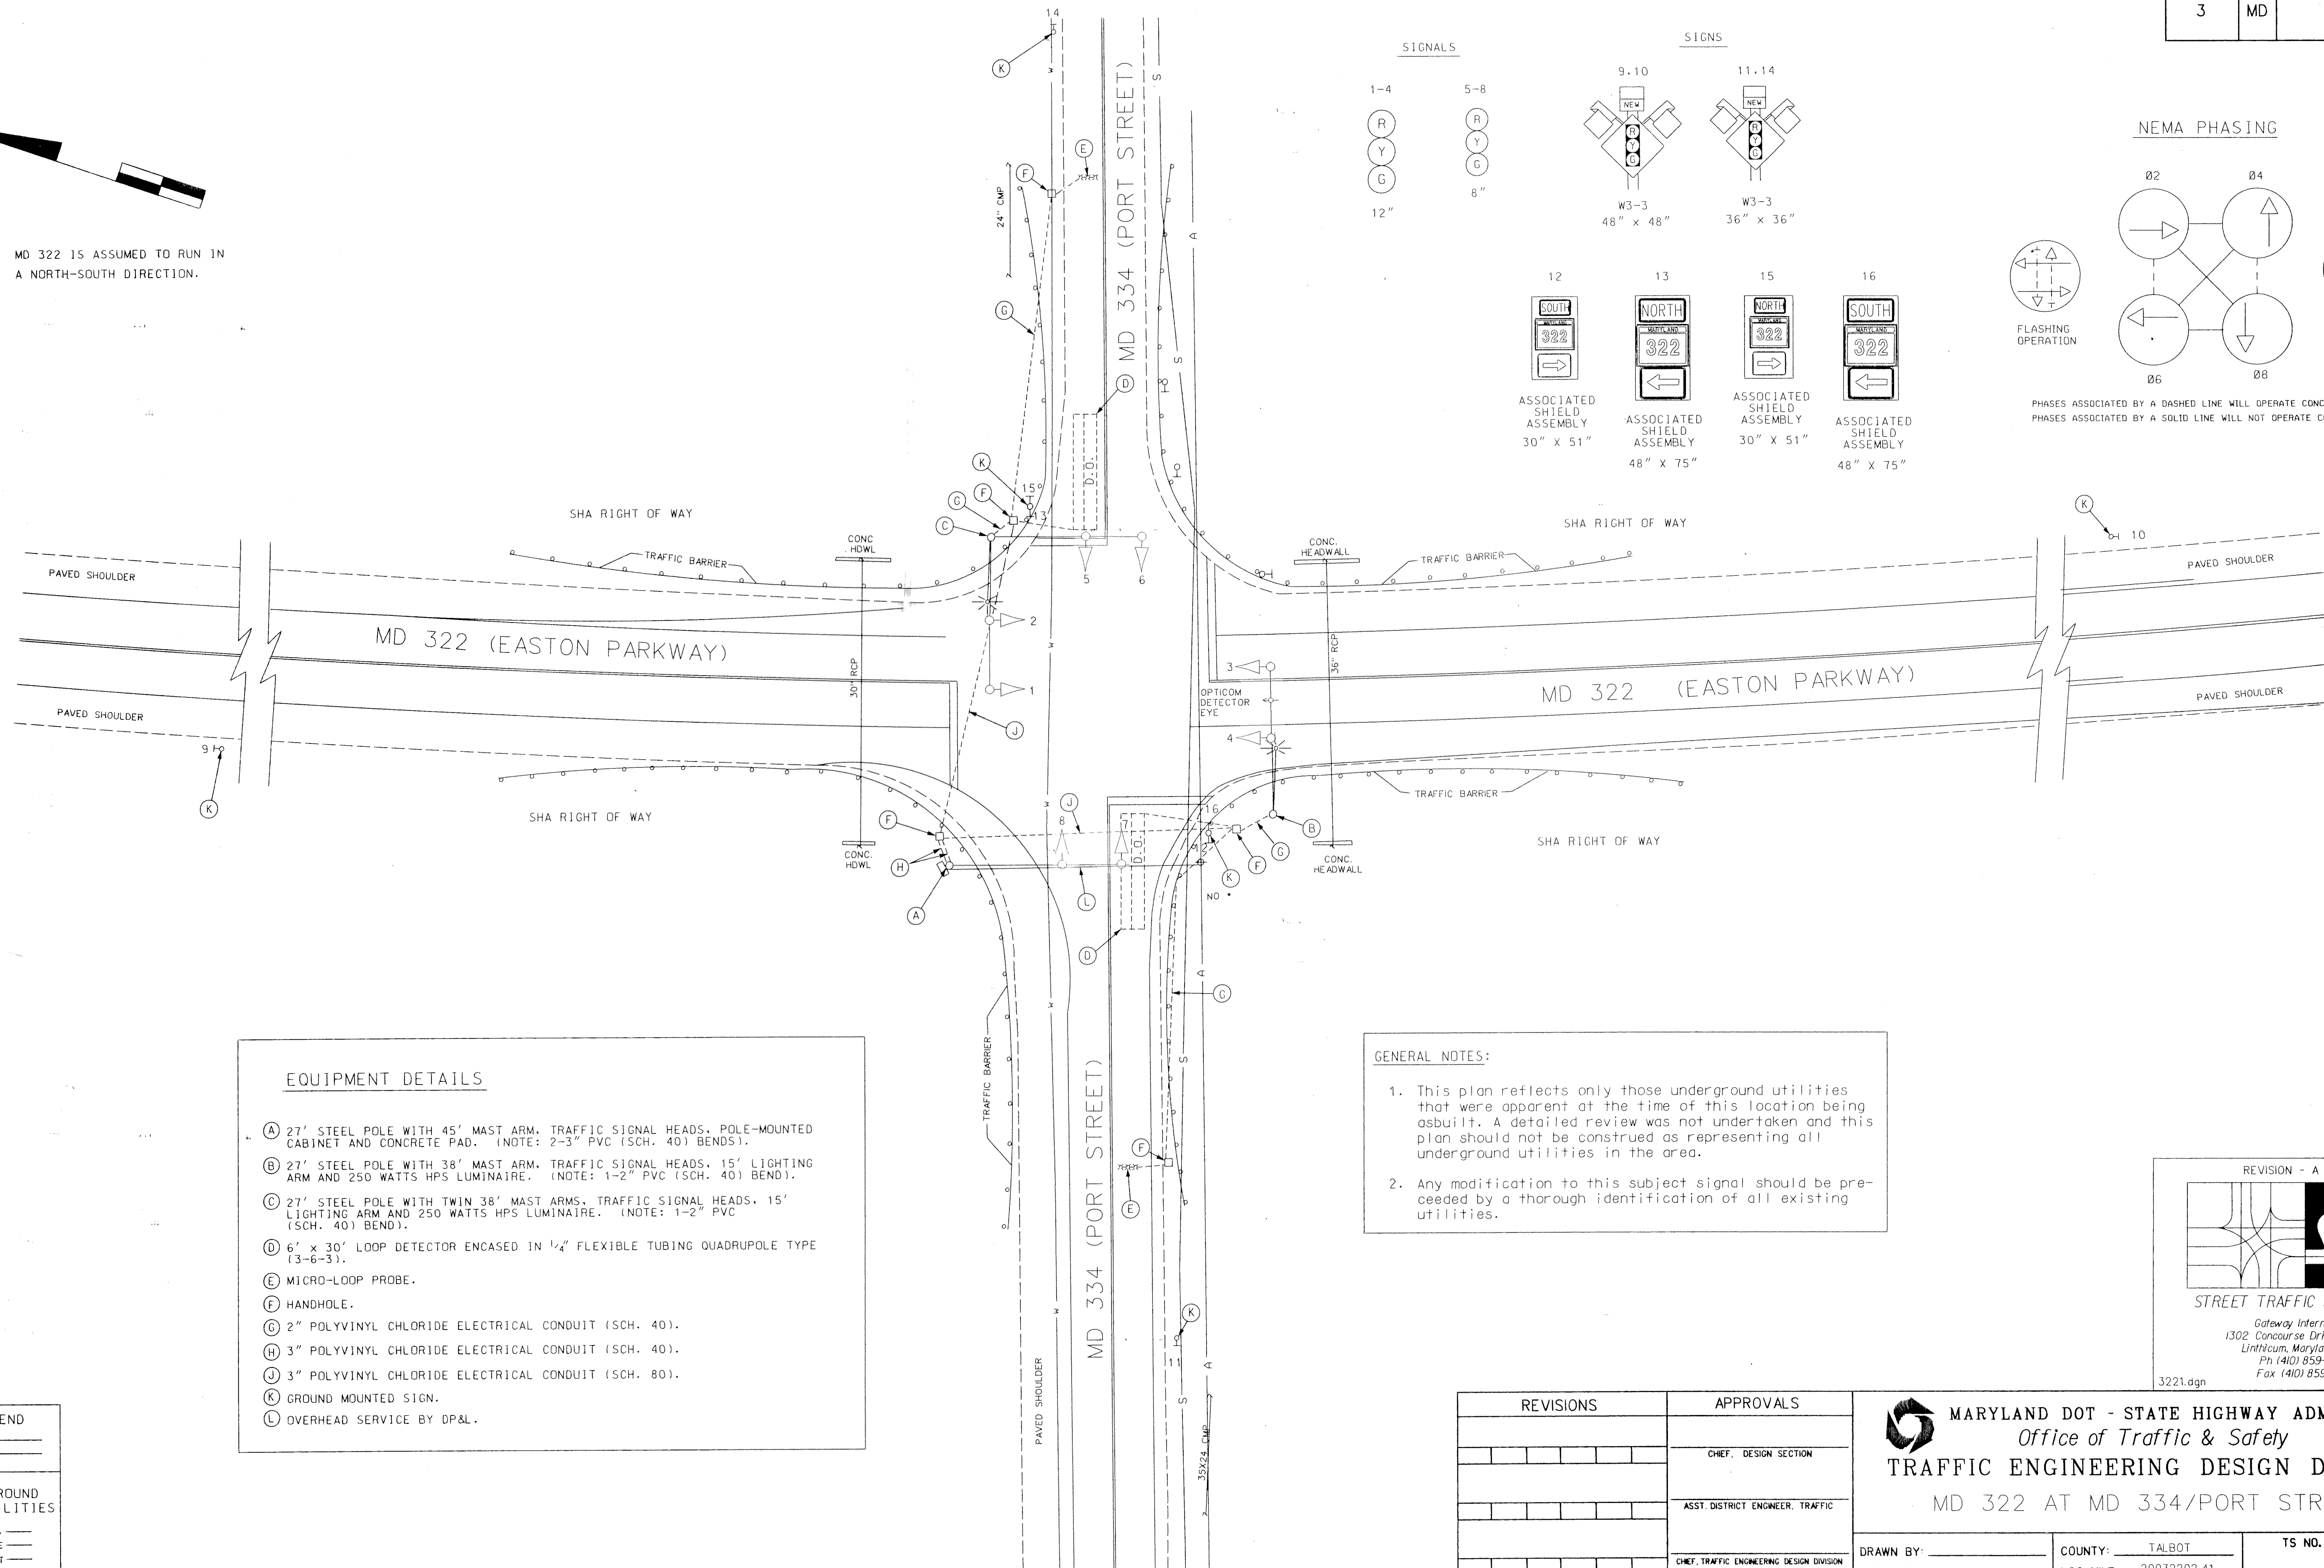


#### EQUIPMENT DETAILS

- (A) 27' STEEL POLE WITH 45' MAST ARM, TRAFFIC SIGNAL HEADS, POLE-MOUNTED CABINET AND CONCRETE PAD. (NOTE: 2-3" PVC (SCH. 40) BENDS).
- (B) 27' STEEL POLE WITH 38' MAST ARM, TRAFFIC SIGNAL HEADS, 15' LIGHTING ARM AND 250 WATTS HPS LUMINAIRE. (NOTE: 1-2" PVC (SCH. 40) BEND).
- (C) 27' STEEL POLE WITH TWIN 38' MAST ARMS, TRAFFIC SIGNAL HEADS, 15' LIGHTING ARM AND 250 WATTS HPS LUMINAIRE. (NOTE: 1-2" PVC (SCH. 40) BEND).
- (D) 6' x 30' LOOP DETECTOR ENCASED IN 1/4" FLEXIBLE TUBING QUADRUPOLE TYPE (3-6-3).
- (E) MICRO-LOOP PROBE.
- (F) HANDHOLE.
- (G) 2" POLYVINYL CHLORIDE ELECTRICAL CONDUIT (SCH. 40).
- (H) 3" POLYVINYL CHLORIDE ELECTRICAL CONDUIT (SCH. 40).
- (J) 3" POLYVINYL CHLORIDE ELECTRICAL CONDUIT (SCH. 80).
- (K) GROUND MOUNTED SIGN.
- (L) OVERHEAD SERVICE BY DP&L.

#### GENERAL NOTES:

- This plan reflects only those underground utilities that were apparent at the time of this location being asbuilt. A detailed review was not undertaken and this plan should not be construed as representing all underground utilities in the area.
- Any modification to this subject signal should be preceded by a thorough identification of all existing utilities.

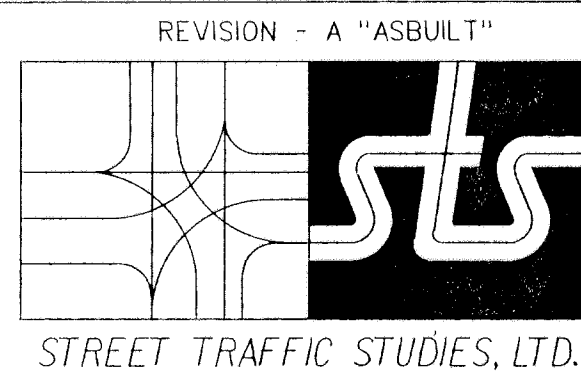

Gateway International  
1302 Concourse Drive, Suite 104  
Linthicum, Maryland 21090  
Ph (410) 859-3553  
Fax (410) 859-3579

3222.dgn

REVISIONS	APPROVALS
	CHEF, DESIGN SECTION
	ASST. DISTRICT ENGINEER, TRAFFIC
	CHEF, TRAFFIC ENGINEERING DESIGN DIVISION
	DIRECTOR, TRAFFIC & SAFETY
6-9-97 AS-BUILT SHA NO. AW-101-501-085	



MARYLAND DOT - STATE HIGHWAY ADMINISTRATION  
Office of Traffic & Safety  
TRAFFIC ENGINEERING DESIGN DIVISION  
MD 322 AT MD 334/PORT STREET

DRAWN BY:	COUNTY: TALBOT	TS NO.	SHEET NO.
CHECK BY:	LOG MILE: 20032202.41		
DATE: 10 / 07 / 96	F.A.P. NO. STPG-0005(49)E	T.J.M.S. NO.	1 OF 1
SCALE: 1"=20'	S.H.A. NO. AW-101-501-085	TS-3625A	

GEOMETRIC LEGEND	
PROPOSED	_____
EXISTING	_____
LEGEND OF UNDERGROUND AND OVERHEAD UTILITIES	
AERIAL CABLE	A
ELECTRIC	E
TELEPHONE	T
GAS	G
SEWER	S
WATER	W
CABLE TV	TV